LABOR AND MATERIALS

1	Copper Lead } Connection	3/4	$ 2.29
1	Curb { Cock Valve T. S. & V. }	3/4 in.	$ 2.70
1	Service Box Old returned { Short 3⅛x4½ Long 4⅛x5⅛ Buff or Rdway }		$ 4.25
32	Ft. 3/4 in. { Copper Galv Iron Cast Iron } Pipe at	35	$ 11.20
	Nipples ..... in. at		$
	Bushings ..... to ..... in. at		$
	Red'g Inc'g } Couplings ..... to ..... in. at		$
	Union ..... in. at		$ 3.96
	Meter ..... in. at		$ 3.72
	Lead Joints at		$
	Leadite Joints at		$
4	Hrs. Foreman at WMM-1- 1.17		$ 7.84
5	Hrs. Chauffeur at 2- 1.07		$ 5.16
	Hrs. Tapper at		$
22	Hrs. Labor at	91	$ 20.02
1	Hrs. Labor at		$
1	Hrs. Compressor at		$ 1.20
	Compensation Ins.		$ .73
	Trucking		$ 1.2
	Builders Use of Water B.P		$
	Map by Wolfsmith		$
			$
			$
			$
			$ 56.33

~~St.~~
~~Pl.~~
Harrison Ave. No. 4B+48½

Name of Owner

Labor and Mat'l. Report June 28 1920

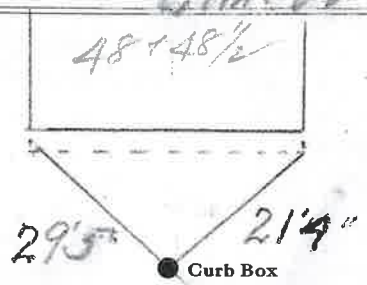

4 Main — Elev. of Main at tap 4½

Gate at ● ● Gate at

● Curb Box

Pd
5 to Pond