Labor and Materials

1	Copper / ~~Lead~~ Connection	3/4"	$ 1.46
1	Curb — Cock / Valve / T. S. & V.	3/4" in	$ 1.93
1	Service Box — Old returned — ~~Short 3½ x 4½~~ / Long 4½ x 5½ / Buff. or ~~Rdway~~		$ 1.47
10 Ft.	3/4" in. — Copper / Galv. Iron / Cast Iron — Pipe at	27	$ 2.20
	Nipples in. at		$
	Bushings to in. at		$
	Red'g / Inc'g Couplings to in. at		$
	Union in. at		$
	Meter in. at		$
	Lead Joints at		$
	Leadite Joints at		$
	Hrs. Foreman at		$
4	Hrs. Chauffeur at	62½	$ 2.50
4	Hrs. Tapper at	62½	$ 2.50
14	Hrs. Labor at	45	$ 6.30
	Hrs. Labor at		$
	Hrs. Compressor at		$
	Compensation Ins.		$ .35
	Trucking		$ 1.00
	Builders Use of Water	Patch	$ 5.00
			$
			$
			$
	Tapmarch by Penn		$
			$25.01

3 5-1937

~~St.~~ / ~~Pl.~~ Harrison Ave. No. 5

Name of Owner

Myers.

Labor and Mat'l. Report June 28 1937

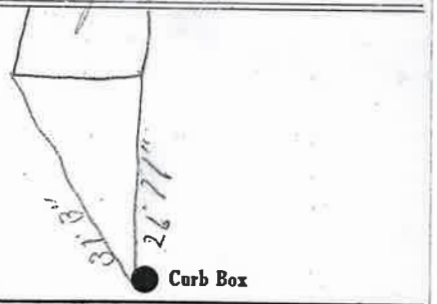

4" Main

Elev. of Main at tap 6'4"

Gate at ● ● Gate at

TAX ID # 302.20-1-9

● Curb Box

Old tap shut off