Labor and Materials

1	Lead Connection	3/4	$
1	Curb Cock	3/4	$
1	Service Box Old returned { Short 3½ x 4½ / ~~Long 4½ x 6½~~ Buffalo }		$
5	Ft. 3/4 in. G. I. Pipe at		$
	Nipples in. at		$
	Bushings to in. at		$
	Red'g Coup to in. at		$
	Inc'g Coup to in. at		$
	Union in. at		$
	Meter in. at		$
	Cu. Yds. Br. Stone at		$
	Cu. Yds. Sand at		$
	Bags Cement at		$
	Paving Brick { Mack / Red / Asphalt } at		$
2	Hrs. Foreman at		$
1	Hrs. Common Labor at		$
	Hrs. Mason at		$
	Hrs. Pearl at		$
	Hrs. at		$
	Builders' Use of Water		$
	at		$
	at		$
	at		$
	at		$
	Total		$

Labor and Material Report 1925 1925

49 Harrison Ave.

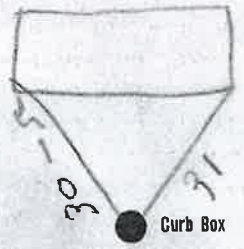

4 Main

Elev. of Main at tap 4

Gate at

Gate at

TAX ID # 302.19-16-16

Curb Box