LABOR AND MATERIALS

1	Copper / ~~Lead~~ Connection	3/4"	$ 2.71
1	Curb { Cock / ~~Valve~~ / ~~T. S. & V.~~ }	3/4 in.	$ 3.83
1	Service box { ~~Short 3½ x 4½~~ / Long 4½ x 5½ / ~~Buff or Rdway~~ }		$ 4.69
26	Ft. 3/4 in. { Copper / ~~C. I.~~ / ~~C. I.~~ } Pipe at 45		$ 11.70
	Nipples ____ in. at		$
	Bushings ____ to ____ in. at		$
	Red'g / Inc'g Coupl'gs ____ to ____ in. at		$
	Union ____ in. at		$
	Meter ____ in. at		$
	Lead Joints at		$
	Compound Joints at		$
	Maintenance Foreman		$ 7.40
	Hrs. Water Maint. Man—1 at		$
2	Hrs. Water Maint. Man—2 at 1.24		$ 2.48
	Hrs. Garage Foreman ____ at		$
4	Hrs. Labor— ____ at 1.13		$ 4.52
	Hrs. Compressor at		$
	Compensation Ins. at $ 4.29 per C		$ .30
	Trucking		$ 1.50
	Pav't Patch FAT		$
Tap by Gissord 6-27-55			$
			$
			$
	O'head		$
			$ 31.73

Harrison (Ext.) ~~St.~~ ~~Pl.~~ Ave. No. 59

Name of Owner

A. Jones

Labor and Mat'l. Report 6-27 1955

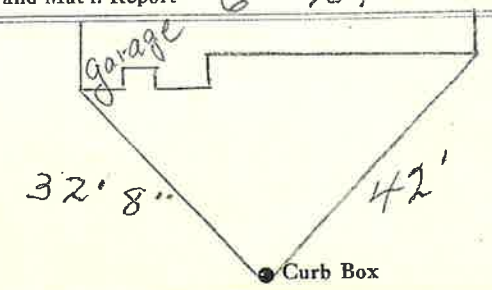

6" Main

Elev. of Main at tap 6'

Gate at ●

● Gate at

● Curb Box

L-M—5C—2-1-54