LABOR AND MATERIALS

1 Copper / ~~Lead~~ } Connection 3/4" ..... $

1 Curb { Cock / Valve / ~~T. S. & V.~~ } 3/4 in. ..... $

1 Service box { Short 3½ x 4½ / ~~Long 4½ x 5½~~ / ~~Buff or Rdway~~ } ..... $

76 Ft. 3/4 in. { Copper / ~~G. I.~~ / ~~C. I.~~ } Pipe at ..... $

..... Nipples ..... in. at ..... $

..... Bushings ..... to ..... in. at ..... $

..... Red'g / Inc'g } Coupl'gs ..... to ..... in. at ..... $

..... Union ..... in. at ..... $

..... Meter ..... in. at ..... $

..... Lead Joints at ..... $

..... Compound Joints at ..... $

..... Maintenance Foreman ..... $

..... Hrs. Water Maint. Man—1 at ..... $

..... Hrs. Water Maint. Man—2 at ..... $

..... Hrs. Garage Foreman ..... at ..... $

..... Hrs. Labor— ..... at ..... $

..... Hrs. Compressor at ..... $

..... Compensation Ins. at $ ..... per C ..... $

..... Trucking ..... $

..... Pay't Patch ..... $

Tap by Gifford & Co. 6-25-56 ..... $

..... $

..... O'head ..... $

..... $

St.
Pl.
Harrison Ave. No. 61

Name of Owner

A. Jones

Labor and Mat'l. Report June 25 1956

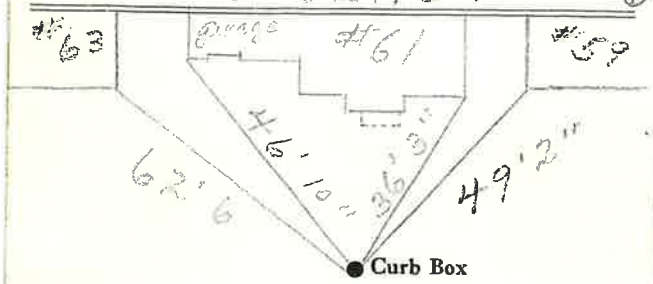

6" Main

Elev. of Main at tap 5'

Gate at ● ● Gate at

● Curb Box

Lot Tap
New House.

LSM—5C—2-5-56