LABOR AND MATERIALS

1 ~~Copper Lead~~ Connection _____ $_____

1 Curb ~~Cock Valve T. S. & V.~~ _____ in. _____ $_____

1 Service box ~~Old returned~~ ~~Short 3½ x 4½ Long 4½ x 5½ Buff or Rdway~~ _____ $_____

27 Ft. ¾ in. ~~Copper G. I. C. I.~~ Pipe at _____ $_____

_____ Nipples _____ in. at _____ $_____

_____ Bushings _____ to _____ in. at _____ $_____

_____ Red'g Inc'g Coupl'gs _____ to _____ in. at _____ $_____

_____ Union _____ in. at _____ $_____

_____ Meter _____ in. at _____ $_____

_____ Lead Joints at _____ $_____

_____ Compound Joints at _____ $_____

_____ Maintenance Foreman _____ $_____

_____ Hrs. Water Maint. Man—1 at _____ $_____

_____ Hrs. Water Maint. Man—2 at _____ $_____

_____ Hrs. Garage Foreman _____ at _____ $_____

_____ Hrs. Labor— _____ at _____ $_____

_____ Hrs. Compressor at _____ $_____

_____ Compensation Ins. at $_____ per C _____ $_____

_____ Trucking _____ $_____

_____ Pav't Patch _____ $_____

Tap by Gissard 6-22-56 _____ $_____

_____ $_____

_____ $_____

_____ O'head _____ $_____

$_____

V

~~St.~~ ~~Pl.~~ Harrison Ave. No. 67

Name of Owner

A. Jones

Labor and Mat'l. Report June 22 1956

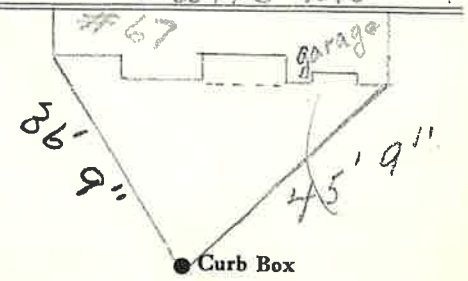

6" Main Elev. of Main at tap 5'

Gate at • • Gate at

• Curb Box

LSM—5C—2-5 56