Labor and Materials

1	Copper ~~Lead~~ Connection	3/4	$ 1.23
1	Curb ~~Cock~~ ~~Valve~~ ~~T. S. & V.~~	3/4 in	$ 1.68
1	Service Box Old returned ~~Short 3½ x 4½~~ Long 4½ x 5½ ~~Buff. or Rdway~~		$ 1.75
10 Ft.	3/4 in. ~~Copper~~ ~~Galv Iron~~ ~~Cast Iron~~	Pipe at 15	$ 1.50
	Nipples in. at		$
1	Bushings 1/2 to 3/4 in. at		$ .04
	Red'g Inc'g Couplings to in. at		$
	Union in. at		$
	Meter in. at		$
	Lead Joints at		$
	Leadite Joints at		$
	Hrs. Foreman at		$
2 1/2	Hrs. Chauffeur at	62½	$ 1.56
2	Hrs. Tapper at	"	$ 1.25
6 1/2	Hrs. Labor at	45	$ 2.93
	Hrs. Labor at		$
	Hrs. Compressor at		$
	Compensation Ins.		$ .18
	Trucking		$ 1.00
	Builders Use of Water no patch - B.P.		$ —
	Tapping Machine		$
			$
			$
			$
			$ 13.12

7 8 - 1938

~~St.~~ ~~Pl.~~ Harrison Ave. No. 9

Name of Owner

Rabbins

Labor and Mat'l. Report June 7 1938

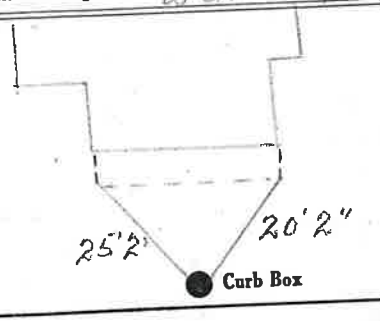

4 Main

Elev. of Main at tap 5

Gate at •

• Gate at

● Curb Box

to be billed old shut off $4