Labor and Materials

1	Copper / ~~Lead~~ Connection	3/4	$ 1.23
1	Curb — Cock / ~~Valve~~ / T. S. & V.	3/4 in	$ 1.68
1	Service Box Old returned — Short 3½ x 4½ / Long 4½ x 5½ / Buff. or Rdway		$ 1.75
9 Ft.	3/4 in. — Copper / Galv Iron / Cast Iron Pipe at		$ 1.35
	Nipples in. at		$
1	Bushings ½ to 3/4 in. at		$ .04
	Red'g / Inc'g Couplings to in. at		$
	Union in. at		$
	Meter in. at		$
	Lead Joints at		$
	Leadite Joints at		$
	Hrs. Foreman at		$
2 1/2	Hrs. Chauffeur at	62½	$ 1.56
2	Hrs. Tapper at	4	$ 1.25
6 1/2	Hrs. Labor at	45	$ 2.93
	Hrs. Labor at		$
	Hrs. Compressor at		$
	Compensation Ins.		$ .18
	Trucking		$ 1.—
	Builders Use of Water hopatch (B.P.)		$
	Tap by Miller		$
			$
			$
			$
			$ 12.97

7 9 - 1938

~~St.~~ ~~Pl.~~ Harrison Ave. No. 11

Name of Owner

Florence Hicks

Labor and Mat'l. Report June 7 1938

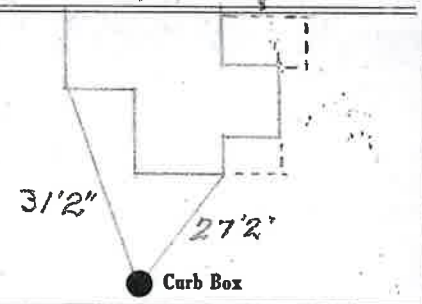

4 Main

Elev. of Main at tap 5

Gate at • • Gate at

• Curb Box

16"-Buried old shut off