LABOR AND MATERIALS

1	Copper / ~~Lead~~ Connection	$1.23
1	Curb { Cock / Valve / ~~T. S. & V.~~ } 3/4 in.	$1.68
1	Service Box / ~~Old returned~~ { Short 3½x4½ / ~~Long 4½x5½~~ / ~~Buff. or Rdway~~ }	$1.54
9	Ft. 3/4 in. { Copper / ~~Galv Iron~~ / ~~Cast Iron~~ } Pipe at	$1.53
	Nipples ____ in. at	$
1	Bushings 3/4" to 1/2 in. at	$ .03
	Red'g / Inc'g Couplings ____ to ____ in. at	$
	Union ____ in. at	$
	Meter ____ in. at	$
	Lead Joints at	$
	Leadite Joints at	$
	Hrs. Foreman at	$
3	Hrs. Chauffeur at 62½	$ 1.88
8	Hrs. Tapper at	$ 5.00
8	Hrs. Labor at 45	$ 3.60
	Hrs. Labor at	$
	Hrs. Compressor at	$
	Compensation Ins.	$ .32
	Trucking	$ 1.—
	Builders Use of Water Patch	$ 5.—
	Tap by Hessel	$
		$
		$
		$
		$ 22.81

4 9 - - 1939

St.
Pl.
Hastell Ave. No. 25

Name of Owner

W.W. Heath Est.

Labor and Mat'l. Report July 31 1939

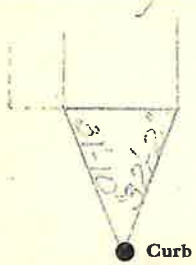

● Curb Box

6" Main — Elev. of Main at tap 3'

Gate at ● ● Gate at

● Curb Box

Old tap disconnected.

M