LABOR AND MATERIALS

Copper / Lead } Connection ..... $.....

Curb { Cock / Valve / T. S. & V. } ..... in. ..... $.....

Service Box / Old returned { Short 3⅛x4⅛ / Long 4⅛x5⅛ / Buff or Rdway } ..... $.....

..... Ft. ..... in. { Copper / Galv Iron / Cast Iron } Pipe at ..... $.....

..... Nipples ..... in. at ..... $.....

..... Bushings ..... to ..... in. at ..... $.....

Red'g / Inc'g } Couplings ..... to ..... in. at ..... $.....

..... Union ..... in. at ..... $.....

..... Meter ..... in. at ..... $.....

..... Lead Joints at ..... $.....

..... Leadite Joints at ..... $.....

..... Hrs. Foreman at ..... $.....

..... Hrs. Chauffeur at ..... $.....

..... Hrs. Tapper at ..... $.....

..... Hrs. Labor at ..... $.....

..... Hrs. Labor at ..... $.....

..... Hrs. Compressor at ..... $.....

..... Compensation Ins. ..... $.....

..... Trucking ..... $.....

..... Builders Use of Water ..... $.....

..... $.....

..... $.....

..... $.....

..... $.....

$.....

St.
Pl.
Ave. No. 29

Haskell

Name of Owner

Labor and Mat'l. Report SEP 5 - 1939 19

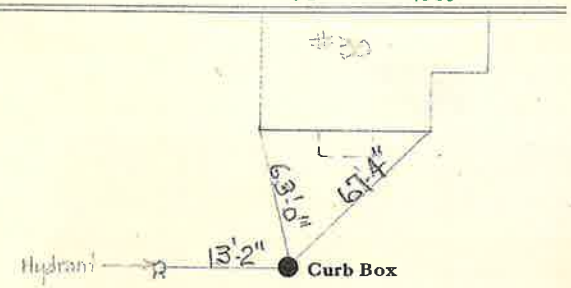

..... Main

Elev. of Main at tap .....

Gate at ●

● Gate at

● Curb Box