Labor and Materials

1	Copper / ~~Lead~~ Connection	3/4	$ 1.43
1	Curb — Cock / ~~Valve~~ / T. S. & V.	3/4	$ 1.88
1	Service Box Old returned — Short 3½ x 4½ / ~~Long 4½ x 5½~~ / Buff. or Rdway		$ 1.75
28 Ft. 2 in.	Copper / ~~Galv. Iron~~ / Cast Iron Pipe at	3/4	$ 5.04
	Nipples ..... in. at		$
	Bushings ..... to ..... in. at		$
	Red'g / Inc'g Couplings ..... to ..... in. at		$
	Union ..... in. at		$
	Meter ..... in. at		$
	Lead Joints at		$
	Leadite Joints at		$
	Hrs. Foreman at		$
8	Hrs. Chauffeur at 62½		$ 5.00
12	Hrs. Tapper at		$ 7.50
12	Hrs. Labor at 45		$ 5.40
	Hrs. Labor at		$
2	Hrs. Compressor at 87½		$ 1.75
	Compensation Ins.		$ .55
	Trucking		$ 1.00
	Builders Use of Water Patch		$ 5.00
	Taping Vessel		$
			$
			$
			$
			$ 36.30

1 2 1938

St. Pl. Haskell Ave. No. 40

Name of Owner

Buckley

Labor and Mat'l. Report April 16 1938

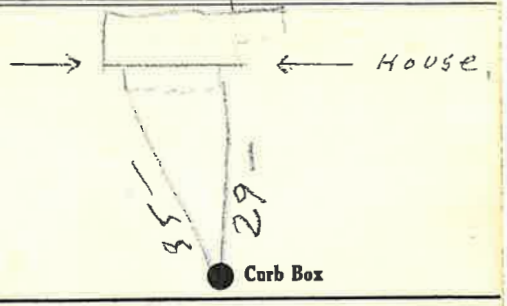

6" Main

Elev. of Main at tap 4½

Gate at ● ● Gate at

TAX ID # 303.18-10-13

● Curb Box

Old tap disconnected.
From House
Left - 41'
Right - 35' 6"