LABOR AND MATERIALS

Copper Lead } Connection _____ $_____

Curb { Cock / Valve / T. S. & V. } _____ in. _____ $_____

Service box Old returned { Short 3½ x 4½ / Long 4½ x 5½ } _____ $_____

_____ Ft. _____ in. { Copper / G. I. / C. I. } Pipe at _____ $_____

_____ Nipples _____ in. at _____ $_____

_____ Bushings _____ to _____ in. at _____ $_____

Red'g Inc'g } Coupl'gs _____ to _____ in. at _____ $_____

_____ Union _____ in. at _____ $_____

_____ Meter _____ in. at _____ $_____

_____ $_____

_____ Compound Joints at _____ $_____

_____ Maintenance Foreman _____ $_____

_____ Hrs. Water Maint. Man—1 at _____ $_____

_____ Hrs. Water Maint. Man—2 at _____ $_____

_____ Hrs. Garage Foreman _____ at _____ $_____

_____ Hrs. Labor— _____ at _____ $_____

_____ Hrs. Compressor at _____ $_____

_____ $_____

_____ Trucking _____ $_____

_____ Pav't Patch _____ $_____

_____ $_____

_____ $_____

_____ $_____

_____ $_____

HASKELL ~~St.~~ ~~Pl.~~ Ave. No. 40½

Name of Owner

Labor and Mat'l. Report 19

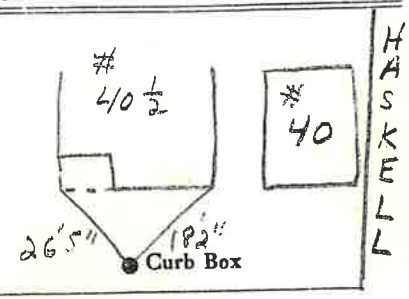

EAST AVE

Main

Elev. of Main at tap

Gate at ●

● Gate at

● Curb Box

TAP ON EAST AVE.

LSM—5C—6-1-67