LABOR AND MATERIALS

1 Copper / ~~Lead~~ } Connection 3/4" $

1 Curb { Cock / ~~Valve~~ / ~~T.S. & V.~~ } 3/4 in. $

1 Service box Old returned { Short 3½ x 4½ / ~~Long 4½ x 5½~~ / ~~Buff or Rdway~~ } $

8 Ft. 3/4 in. { Copper / ~~G.I.~~ / ~~C.I.~~ } Pipe at $

Nipples in. at $

Bushings to in. at $

Red'g / Inc'g } Coupl'gs to in. at $

Union in. at $

Meter in. at $

Lead Joints at $

Compound Joints at $

Maintenance Foreman $

Hrs. Water Maint. Man—1 at $

Hrs. Water Maint. Man—2 at $

Hrs. Garage Foreman at $

Hrs. Labor— at $

Hrs. Compressor at $

Compensation Ins. at $ per C $

Trucking $

Pav't Patch $

Tap by Gisseard & Co. 6-2 $

$

$

O'head $

$

Haskell St. / Pl. / Ave. No. 71

Name of Owner Rolland Phillips

Labor and Mat'l. Report June 20 1962

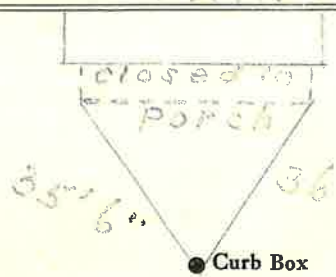

6" Main

Elev. of Main at tap 5'

Gate at ●

● Gate at

● Curb Box

LSM—5C—3-10-61

35' 6" 36'