LABOR AND MATERIALS

1	Copper / ~~Lead~~ Connection 3/4		$ 1.78
1	Curb { Clock / ~~Valve~~ / ~~T. S. & V.~~ } 3/4 in.		$ 2.61
1	Service box / ~~Old returned~~ { Short 3½X4½ / Long 4½X5½ / Buff or Rdway }		$ 1.82
34	Ft. 3/4 in. { Copper / ~~Galv. Iron~~ / ~~Cast Iron~~ } Pipe at 23		$ 7.82
	Nipples in. at		$
	Bushings to in. at		$
	Red'g / Inc'g Couplings to in. at		$
	Union in. at		$
	Meter in. at		$
	Lead Joints at		$
	Compound Joints at		$
1	Hrs. ~~Foreman at~~ WWM	92½	$ .93
12	Hrs. Chauffeur at	82½	$ 9.90
	Hrs. Tapper at		$
26	Hrs. Labor at	71½	$ 18.59
	Hrs. Labor at		$
3	Hrs. Compressor at	87½	$ 2.62
	Compensation Ins.		$ .81
	Trucking		$ 1.00
	Builders Use of Water ? Patch		$ 5.00
	Taply Warsinski		$
			$
			$
			$
			$ 52.88

19-146

Haskell Ave St. Pl. Ave. No. 80

Name of Owner

Polunci

Labor and Mat'l. Report Sept 10 1946

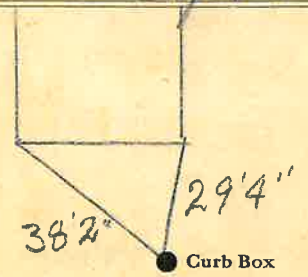

6 Main

Elev. of Main at tap 7

Gate at ● ● Gate at

TAX ID # 303.14-4-5

● Curb Box

LSM-5C-6-1-45