Void

~~St.~~
~~Pl.~~
Ave. No. 12-14

Haskell

Name of Owner Saved For Haskell Factory Reference

~~Labor and Mat'l. Report~~ Jan 11 1946

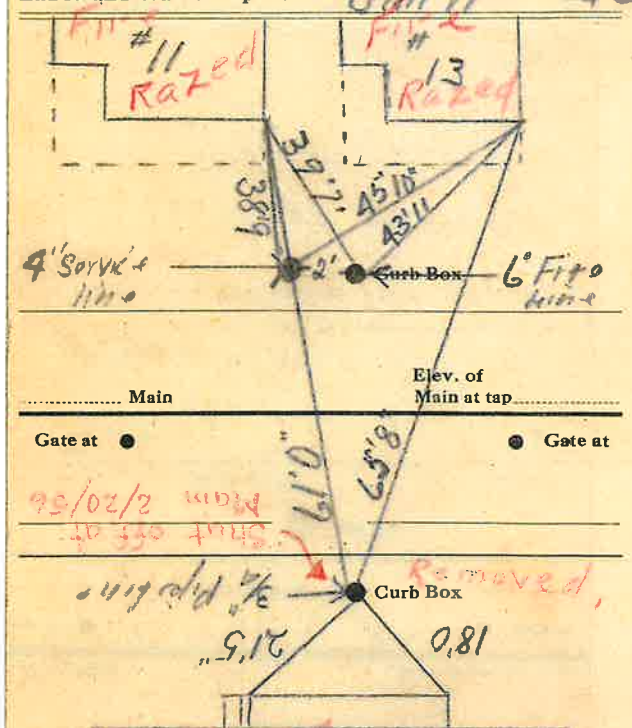

LSM-5C-6-1-45

Void

~~St.~~
~~Pl.~~
Ave. No. 12-14

Haskell

Name of Owner Saved For Haskell Factory Reference

~~Labor and Mat'l. Report~~ Jan 11 1946

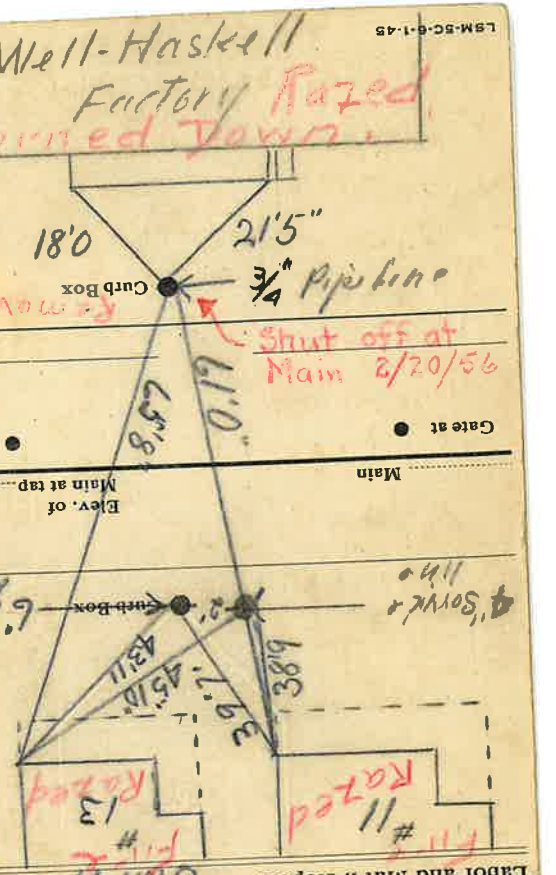

LSM-5C-6-1-45

LABOR AND MATERIALS

Copper / Lead } Connection ..... $.....

Curb { Clock / Valve / T. S. & V. } ..... in. ..... $.....

Service box / Old returned { Short 3½X4½ / Long 4½X5½ / Buff or Rdway } ..... $.....

..... Ft. ..... in. { Copper / Galv. Iron / Cast Iron } Pipe at ..... $.....

..... Nipples ..... in. at ..... $.....

..... Bushings ..... to ..... in. at ..... $.....

Red'g / Inc'g } Couplings ..... to ..... in. at ..... $.....

..... Union ..... in. at ..... $.....

..... Meter ..... in. at ..... $.....

..... Lead Joints at ..... $.....

..... Compound Joints at ..... $.....

..... Hrs. Foreman at ..... $.....

..... Hrs. Chauffeur at ..... $.....

..... Hrs. Tapper at ..... $.....

..... Hrs. Labor at ..... $.....

..... Hrs. Labor at ..... $.....

..... Hrs. Compressor at ..... $.....

..... Compensation Ins. ..... $.....

..... Trucking ..... $.....

..... Builders Use of Water ..... $.....

Warsinske + Geo ..... $.....

..... $.....

..... $.....

..... $.....

$.....