LABOR AND MATERIALS

1	Copper / ~~Lead~~ Connection	3/4"	$ 2.76
1	Curb: Cock / Valve / T. S. & V.	3/4 in.	$ 3.49
1	Service box Old returned: ~~Short 3½X4½~~ / Long 4½X5½ / ~~Buff or Rdway~~		$ 4.74
9	Ft. 3/4 in. Copper / G. I. / C. I. Pipe at 38		$ 3.42
	Nipples ... in. at		$
	Bushings ... to ... in. at		$
	Red'g Inc'g Coupl'gs ... to ... in. at		$
	Union ... in. at		$
	Meter ... in. at		$
	Lead Joints at		$
	Compound Joints at		$
	Hrs. Water Maint. Man—1 at		$
5	Hrs. Water ~~Maint. Man—2~~ at Eman 1.89		$ 7.95
	Hrs. Labor— ... at		$
5	Hrs. Labor— ... at 1.13		$ 5.25
	Hrs. Compressor at		$
	Compensation Ins. at $ 4.06 per C		$ 6.0
	Trucking		$ 1.00
	Pav't Patch		$ 9.00
	Tap by Gissend 9-16-53		$
			$
	O'head		$
			$ 38.61

29.61

77-53

~~St.~~ ~~Pl.~~ Haviland Ave. No. 11

Name of Owner

Preston

Labor and Mat'l. Report Sept. 16 1953

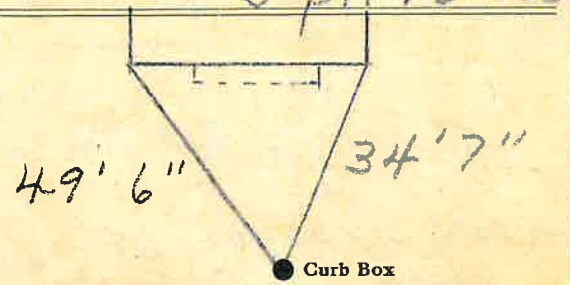

4" Main

Elev. of Main at tap 5'

Gate at ● ● Gate at

● Curb Box

LSM-3C 5 15-48