LABOR AND MATERIALS

1 Copper / Lead } Connection 3/4 ..... $ 1.35

1 Curb { Cock / ~~Valve~~ / ~~T. S. & V.~~ } { 3/4 } in. ..... $ 1.80

Service Box Old returned { ~~Short 3½x4½~~ / ~~Long 4½x5½~~ / ~~Buff or Rdway~~ } Same $ —

11 Ft. 3/4 in. { Copper / ~~Galv Iron~~ / ~~Cast Iron~~ } Pipe at 15 $ 1.65

Nipples ..... in. at ..... $ .....

Bushings ..... to ..... in. at ..... $ .....

Red'g / Inc'g } Couplings ..... to ..... in. at ..... $ .....

Union ..... in. at ..... $ .....

Meter ..... in. at ..... $ .....

Lead Joints at ..... $ .....

Leadite Joints at ..... $ .....

Hrs. Foreman at ..... $ .....

2 Hrs. Chauffeur at 62½ $ 1.25

1/4 Hrs. Tapper at 1 $ .25

4 Hrs. Labor at 45 $ 1.80

Hrs. Labor at ..... $ .....

Hrs. Compressor at ..... $ .....

Compensation Ins. ..... $ .17

Trucking ..... $ 1.—

Builders Use of Water Patch $ .5—

Tap by Hessel ..... $ .....

..... $ .....

..... $ .....

..... $ .....

$ 16.35

9 2 1941

~~St.~~ / ~~Pl.~~ 15

Haviland Ave. No. 19

Name of Owner

John Petetier

Labor and Mat'l. Report Aug 29 19 41

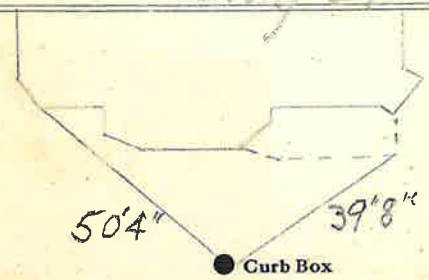

1 Main

Elev. of Main at tap

Gate at ●

● Gate at

● Curb Box