LABOR AND MATERIALS

1" Copper / ~~Lead~~ } Connection _____ $ _____

1" Curb } Cock / Valve / T.S. & V. } 1" in. _____ $ _____

_____ Service box / Old returned { Short 3-1/2 x 4-1/2 / Long 4-1/2 x 5-1/2 } _____ $ _____

51 Ft. _____ in. { Copper / ~~Cat.~~ / ~~Cat.~~ } Pipe at _____ $ _____

_____ Nipples _____ in. at _____ $ _____

_____ Bushings _____ to _____ in. at _____ $ _____

_____ Red'g

_____ Inc'g

_____ Union _____ in. at _____ $ _____

_____ Meter _____ in. at _____ $ _____

_____ _____ $ _____

_____ Compound Joints at _____ $ _____

_____ Maintenance Foreman _____ $ _____

_____ Hrs. Water Maint. Man - 1 at _____ $ _____

_____ Hrs. Water Maint. Man - 2 at _____ $ _____

_____ Hrs. Garage Foreman _____ at _____ $ _____

_____ Hrs. Labor _____ at _____ $ _____

_____ Hrs. Compressor at _____ $ _____

_____ _____ $ _____

_____ Trucking _____ $ _____

_____ Pav't Patch _____ $ _____

_____ _____ $ _____

_____ _____ $ _____

_____ _____ $ _____

_____ _____ $ _____

$ _____

Henry st. St.
Pumping station Pl.
Ave. No. _____

Name of Owner

City of Glens Falls

Labor and Mat'l. Report ● 5/5/2009

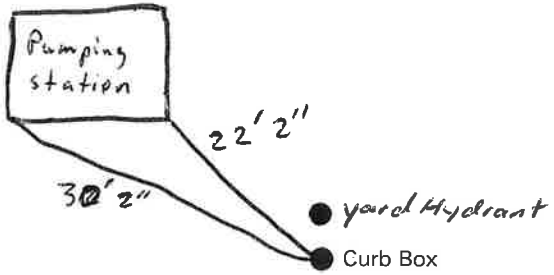

6" Main

Elev. of Main at tap 8'

Gate at ●

● Gate at

_____ _____

● Curb Box