## LABOR AND MATERIALS

| | | | |
|---|---|---|---|
| 1 | Copper / ~~Lead~~ Connection | 3/4 | $ 1.23 |
| 1 | Curb { Cock / ~~Valve~~ / ~~T. S. & V.~~ } | 3/4 in. | $ 1.68 |
| 1 | Service Box Old returned { Short ~~3½x4½~~ / Long ~~4½x5½~~ / ~~Buff. or Rdway~~ } | | $ 1.75 |
| 9 | Ft. 3/4 in. { Copper / ~~Galv Iron~~ / ~~Cast Iron~~ } Pipe at | | $ 1.35 |
| | Nipples ____ in. at | | $ |
| | Bushings ____ to ____ in. at | | $ |
| | Red'g / Inc'g Couplings ____ to ____ in. at | | $ |
| | Union ____ in. at | | $ |
| | Meter ____ in. at | | $ |
| | Lead Joints at | | $ |
| | Leadite Joints at | | $ |
| | Hrs. Foreman at | | $ |
| 6 | Hrs. Chauffeur at | 60¢ | $ 3.75 |
| 8 | Hrs. Tapper at | | $ 5.40 |
| | Hrs. Labor at | | $ |
| | Hrs. Labor at | | $ |
| 2 | Hrs. Compressor at | 87½ | $ 1.75 |
| | Compensation Ins. | | $ .27 |
| | Trucking | | $ 1.00 |
| | Builders Use of Water Peter Burns | | $ .50 |
| | Tap by Hessell | | $ |
| | | | $ |
| | | | $ |
| | | | $ 20.28 |

162-1132

St.
Pl.
Ave. No. 16

Name of Owner

Mann

Labor and Mat'l. Report Nov 30 19

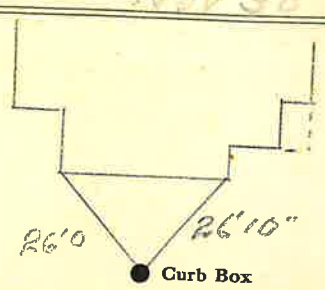


6 Main

Elev. of Main at tap 5½

Gate at ● ● Gate at

● Curb Box

old shutoff