LABOR AND MATERIALS

1	Copper ~~Lead~~ Connection	3/4"	$ 1.31
1	Curb Cock ~~Valve~~ ~~T. S. & V.~~	3/4 in.	$ 1.75
1	Service Box ~~Old returned~~ Short 3½x4½ / Long 4½x5½ / ~~Buff. or Rdway~~		$ 1.60
7	Ft. 3/4 in. Copper / ~~Galv Iron~~ / ~~Cast Iron~~ Pipe at 18		$ 1.26
	Nipples ____ in. at		$
	Bushings ____ to ____ in. at		$
	Red'g / Inc'g Couplings ____ to ____ in. at		$
	Union ____ in. at		$
	Meter ____ in. at		$
	Lead Joints at		$
	Leadite Joints at		$
	Hrs. Foreman at		$
3	Hrs. Chauffeur at	62½	$ 1.88
	Hrs. Tapper at		$
6	Hrs. Labor at	45	$ 2.70
	Hrs. Labor at		$
1	Hrs. Compressor at	62½	$ .63
	Compensation Ins.		$ .14
	Trucking		$ 1.—
	Builders Use of Water	½ Patch (Sewer)	$ 2.50
			$
			$
			$
	Tap by Penner		$
			$ 14.77

12 - 1940

St.
~~Pl.~~
Henry Ave. No. 20

Name of Owner
Cooney

Labor and Mat'l. Report 9/23/40 19

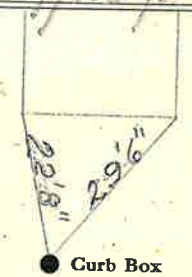

6" Main

Elev. of Main at tap 6½'

Gate at ●

● Gate at

● Curb Box

Dug up at Main + Shut off 9-23-40