LABOR AND MATERIALS

____	Copper / Lead Connection	____	$ ____
____	Curb Cock / Valve / T.S. & V.	____ in.	$ ____
____	Service box / Old returned Short 3-1/2 x 4-1/2 / Long 4-1/2 x 5-1/2	____	$ ____
____	Ft. ____ in. Copper / G.I. / C.I. Pipe at	____	$ ____
____	Nipples ____ in. at	____	$ ____
____	Bushings ____ to ____ in. at	____	$ ____
____	Red'g		
____	Inc'g		
____	Union ____ in. at	____	$ ____
____	Meter ____ in. at	____	$ ____
____			$ ____
____	Compound Joints at	____	$ ____
____	Maintenance Foreman	____	$ ____
____	Hrs. Water Maint. Man - 1 at	____	$ ____
____	Hrs. Water Maint. Man - 2 at	____	$ ____
____	Hrs. Garage Foreman ____ at	____	$ ____
____	Hrs. Labor ____ at	____	$ ____
____	Hrs. Compressor at	____	$ ____
____			$ ____
____	Trucking	____	$ ____
____	Pav't Patch	____	$ ____
____			$ ____
____			$ ____
____			$ ____
____			$ ____
			$ ____

Name of Owner: Henry

St. / Pl. / Ave. No. 24

Labor and Mat'l. Report ~~39~~ 11/4/2011

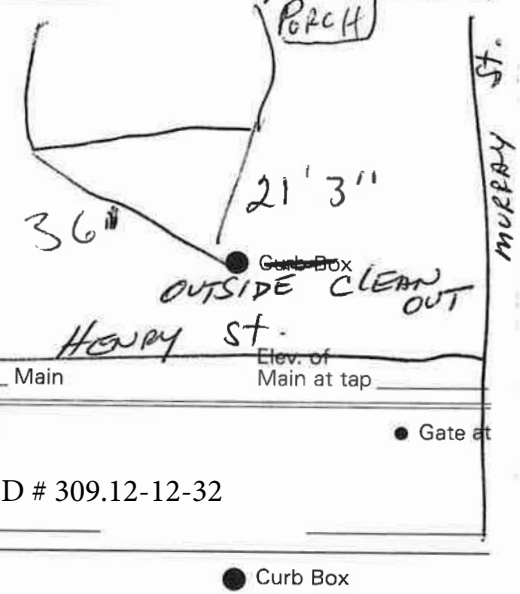

____ Main

Elev. of Main at tap ____

Gate at ●

● Gate at

TAX ID # 309.12-12-32

● Curb Box