LABOR AND MATERIALS

1 Copper / ~~Lead~~ Connection 3/4" $

1 Curb Cock / ~~Valve~~ / ~~I. S. & V.~~ 3/4 in. Used $ Same

1 Service box Old returned ~~Short 3½ x 4½~~ / Long 4½ x 5½ / ~~Buff or Rdway~~ Used Same $

11 Ft. 3/4 in. Copper / ~~C.I.~~ / ~~G.I.~~ Pipe at $

Nipples in. at $

Bushings to in. at $

Red'g / Inc'g Coupl'gs to in. at $

Union in. at $

Meter in. at $

1 ~~Lead Joints~~ at 3/4" Male Adapter $

Compound Joints at $

Maintenance Foreman $

Hrs. Water Maint. Man—1 at $

Hrs. Water Maint. Man—2 at $

Hrs. Garage Foreman at $

Hrs. Labor— at $

Hrs. Compressor at $

Compensation Ins. at $ per C $

Trucking $

Pav't Patch $

$

Tap Made By Pervis $ +6

$

O'head Oct. 18-1973 $

$

St. / ~~Pl.~~ / Ave. No. 34

Henry

Name of Owner

J. Murray

Labor and Mat'l. Report Oct. 18 1973

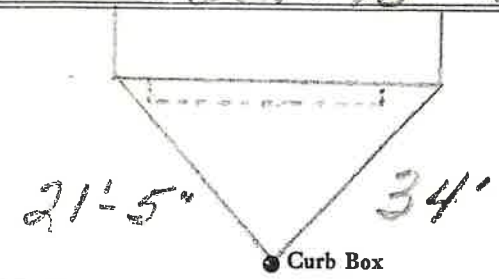

6" Main

Elev. of Main at tap 5½'

Gate at

Gate at

Curb Box

LSM—5C—6-1-67