LABOR AND MATERIALS

1	Copper Lead — Connection	3/4"	$ 2.76
1	Curb — Cock / Valve / T. S. & V.	3/4 in.	$ 3.49
1	Service box — Old returned — Short 3½X4½ / ~~Long 4½X5½~~ / Buff or Rdway		$ 4.74
10	Ft. 3/4 in. — Copper / ~~G. I.~~ / ~~C. I.~~	Pipe at 35	$ 3.50
	Nipples ... in. at		$
	Bushings ... to ... in. at		$
	Red'g Inc'g — Coupl'gs ... to ... in. at		$
	Union ... in. at		$
	Meter ... in. at		$
	Lead Joints at		$
	Compound Joints at		$
	Hrs. Water Maint. Man—1 at		$
10	Hrs. Water Maint. Man—2 at	1.24	$ 12.40
28	Hrs. Labor— ... at	1.13	$ 31.64 44.04
	Hrs. Labor— ... at		$
	Hrs. Compressor at		$
	Compensation Ins. at $3.706 per C		$ 1.63
	Trucking		$ 1.00
	Pav't Patch		$ 5.40
	Tap by Gilliard Oct 7 '52		$
			$
			$
	O'head		$
			$ 67.56

St.
Pl.
Henry Ave. No. 40

Name of Owner
Murray

Labor and Mat'l. Report Oct 7 1952

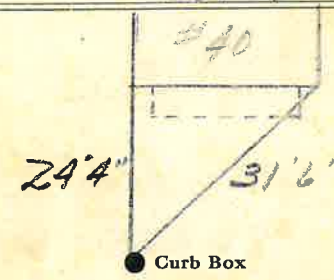

6" Main

Elev. of Main at tap 5'

Gate at ● ● Gate at

● Curb Box

LSM-SC 5 15-48