LABOR AND MATERIALS

1	Copper / Lead } Connection 3/4		$ 1.59
1	Curb { Clock / Valve / T. S. & V. } 3/4 in.		$ 2.74
1	Service box / Old returned { Short 3½X4½ / Long 4½X5½ / Buff or Rdway }		$ 1.82
31	Ft. 3/4 in. { Copper / Galv. Iron / Cast Iron } Pipe at 19		$ 5.89
	Nipples in. at		$
	Bushings to in. at		$
	Red'g / Inc'g } Couplings to in. at		$
	Union in. at		$
	Meter in. at		$
	Lead Joints at		$
	Compound Joints at		$
	Hrs. Foreman at		$
5	Hrs. Chauffeur at	68 3/4	$ 3.44
8	Hrs. Tapper at		$ 5.50
	Hrs. Labor at		$
	Hrs. Labor at		$
	Hrs. Compressor at		$
	Compensation Ins.		$ .28
	Trucking		$ 1—
	Builders Use of Water		$ 5.00
	Tap by Warsiuski		$
			$
			$
			$
			$ 27.26

19, 45

Henry St. ~~Pl.~~ Ave. No. 47

Name of Owner

Brayman

Labor and Mat'l. Report July 24 1945

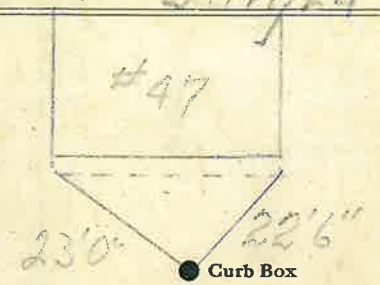

6 Main

Elev. of Main at tap 5

Gate at ● ● Gate at

● Curb Box

LSM-SC-6-1-45