LABOR AND MATERIALS

1	Copper / ~~Lead~~ Connection	3/4"	$ 1.31
1	Curb { Cock / ~~Valve~~ / ~~I. S. & V.~~ }	3/4 in.	$ 1.75
1	Service Box ~~Old returned~~ { Short 3½x4½ / Long 4½x5½ / Buff. or Rdway }		$ 1.60
10	Ft. 3/4 in. { Copper / ~~Galv Iron~~ / ~~Cast Iron~~ } Pipe at 18		$ 1.80
	Nipples ____ in. at		$
	Bushings ____ to ____ in. at		$
	Red'g / Inc'g Couplings ____ to ____ in. at		$
	Union ____ in. at		$
	Meter ____ in. at		$
	Lead Joints at		$
	Leadite Joints at		$
	Hrs. Foreman at		$
6	Hrs. Chauffeur at	62½	$ 3.75
5	Hrs. Tapper at	"	$ 3.12
11	Hrs. Labor at	45	$ 4.95
	Hrs. Labor at		$
	Hrs. Compressor at		$
	Compensation Ins.		$ .36
	Trucking		$ 1.—
	Builders Use of Water	Patch	$ .5—
			$
			$
			$
	Tap by Kessel		$
			$ 24.64

1 1 3 - 1940

St. ~~Pl.~~ Henry Ave. No. 6

Name of Owner

Lester

Labor and Mat'l. Report SEP 2 5 1940 19

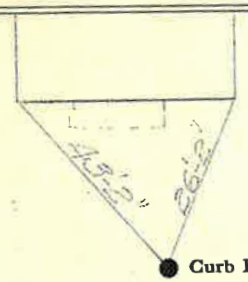

6" Main

Elev. of Main at tap 6'

Gate at ● ● Gate at

TAX ID # 309.12-5-8

● Curb Box

O.K. Tap & shut off.

HH