Labor and Materials

1	Copper / ~~Lead~~ Connection	3/4	$ 1.46
1	Curb Cock / ~~Valve~~ / ~~T. S. & V.~~	3/4 in	$ 1.93
1	Service Box Old returned Short 3½ x 4½ / Long ~~4½ x 5½~~ / Buff. ~~or Rdway~~		$ 1.77
10	Ft. 3/4 in. Copper / ~~Galv. Iron~~ / ~~Cast Iron~~ Pipe at		$ 2.20
	Nipples in. at		$
	Bushings to in. at		$
	Red'g / Inc'g Conplings to in. at		$
	Union in. at		$
	Meter in. at		$
	Lead Joints at		$
	Leadite Joints at		$
	Hrs. Foreman at		$
3	Hrs. Chauffeur at		$ 1.87
5	Hrs. Tapper at		$ 3.13
8	Hrs. Labor at		$ 3.60
	Hrs. Labor at		$
	Hrs. Compressor at		$
	Compensation Ins.		$ 26
	Trucking		$ 1.00
	Builders Use of Water no patch		$ —
			$
			$
			$
	Top [illegible]		$
			$ 17.22

4 - 1938

Horican ~~St.~~ ~~Pl.~~ Ave. No. 11

Name of Owner

W.E. Burdett

Labor and Mat'l. Report May, 25 1938

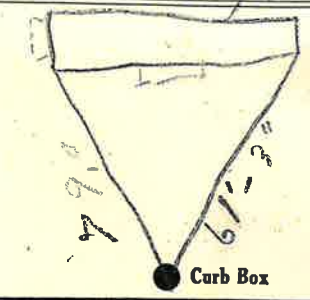

6 Main

Elev. of Main at tap 4½

Gate at

Gate at

Curb Box

old Tap Shut off

Bill this