LABOR AND MATERIALS

1 Copper / ~~Lead~~ } Connection 1" $

1 Curb { Cock / ~~Valve~~ / ~~T. S. & V.~~ } 1 in. $

1 Service box / ~~Old returned~~ { ~~Short 3½ x 4½~~ / ~~Long 4½ x 5½~~ / ~~Buff or Rdway~~ } 6' Long $

31 Ft. 1 in. { Copper / ~~C. I.~~ / ~~C. I.~~ } Pipe at $

Nipples in. at $

Bushings to in. at $

Red'g / Inc'g } Coupl'gs to in. at $

Union in. at $

Meter in. at $

Lead Joints at $

Compound Joints at $

Maintenance Foreman $

Hrs. Water Maint. Man—1 at $

Hrs. Water Maint. Man—2 at $

Hrs. Garage Foreman at $

Hrs. Labor— at $

Hrs. Compressor at $

Compensation Ins. at $ per C $

Trucking $

Pav't Patch $

$

Tap 4/14/80 $

Willett + Co $

O'head $

$

~~St.~~
~~Pl.~~
Horicon Ave. No. 12

Name of Owner

Andrew Brown

Labor and Mat'l. Report April 15 1980

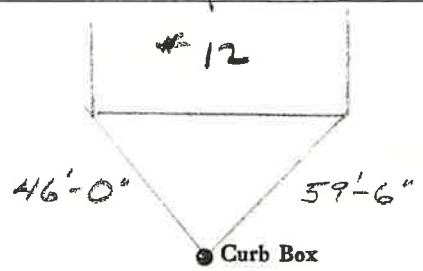

6 Main

Elev. of Main at tap 3½'

Gate at

Gate at

Curb Box

LSM—5C—6-1-67