Labor and Materials

Copper / Lead } Connection ..... $.....

Curb { Cock / Valve / T. S. & V. } ..... in ..... $.....

Service Box Old returned { Short 3½ x 4½ / Long 4½ x 5½ / Buff. or Rdway } ..... $.....

.....Ft. .....in. { Copper / Galv Iron / Cast Iron } Pipe at ..... $.....

Nipples .....in. at ..... $.....

Bushings .....to .....in. at ..... $.....

Red'g / Inc'g } Couplings .....to .....in. at ..... $.....

Union .....in. at ..... $.....

Meter .....in. at ..... $.....

Lead Joints at ..... $.....

Leadite Joints at ..... $.....

Hrs. Foreman at ..... $.....

Hrs. Chauffeur at ..... $.....

Hrs. Tapper at ..... $.....

Hrs. Labor at ..... $.....

Hrs. Labor at ..... $.....

Hrs. Compressor at ..... $.....

Compensation Ins. ..... $.....

Trucking ..... $.....

Builders Use of Water ..... $.....

..... $.....

..... $.....

..... $.....

..... $.....

$.....

St. Pl. Ave. No. 14

Herican

Name of Owner

John H. Coy

Labor and Mat'l. Report 5-24 1922

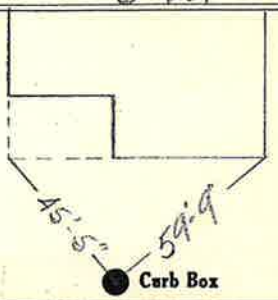

.....Main

Elev. of Main at tap..... .....

Gate at •

• Gate at

• Curb Box