LABOR AND MATERIALS

1	Copper Lead — Connection	3/4	$ 1.23
1	Curb — Cock / Valve / T. S. & V.	3/4 in.	$ 1.18
1	Service Box — Old returned — Short 3½x4½ / Long 4½x5½ / Buff. or Rdway		$ 1.75
11	Ft. 3/4 in. — Copper / Galv Iron / Cast Iron — Pipe at		$ 1.65
	Nipples	in. at	$
	Bushings	to in. at	$
	Red'g / Inc'g — Couplings	to in. at	$
	Union	in. at	$
	Meter	in. at	$
	Lead Joints at		$
	Leadite Joints at		$
	Hrs. Foreman at		$
1	Hrs. Chauffeur at	62½	$ 2.50
1	Hrs. Tapper at	"	$ 2.50
	Hrs. Labor at		$
10	Hrs. Labor at	45	$ 4.50
2	Hrs. Compressor at	87½	$ 1.75
	Compensation Ins.		$ .39
	Trucking		$ 1.00
	Builders Use of Water	Estimate	$ 5.00
Tap by Person			$
			$
			$
			$
			$ 23.85

1 6 4 - 1938

St.
Pl.
Ave. No. 27

Harrison

Name of Owner

Du Trese

Labor and Mat'l. Report Oct 19 1938

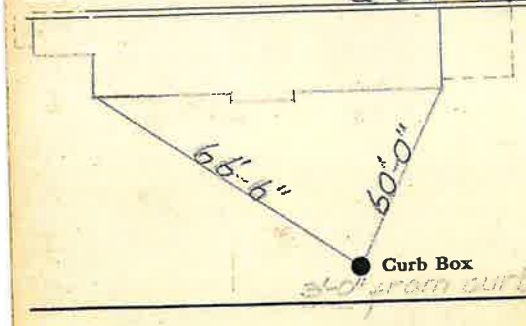

6 Main

Elev. of Main at tap 5

Gate at ●

● Gate at

● Curb Box