## LABOR AND MATERIALS

1 Copper ~~Lead~~ } Connection 1 " ..... $.....

1 Curb { Clock / Valve / T. S. & V. } 1 in. ..... $.....

1 Service box ~~Old returned~~ { ~~Short 3½X4½~~ / Long 4½X5½ / ~~Buff or Rdway~~ } ..... $.....

10 Ft. 1 in. { Copper / ~~Galv. Iron~~ / ~~Cast Iron~~ } Pipe at ..... $.....

1 Nipples ..... in. at ..... $.....

..... Bushings ..... to ..... in. at ..... $.....

1 ~~Red'g~~ / Inc'g } Couplings 1 to 1¼ in. at ..... $.....

..... Union ..... in. at ..... $.....

..... Meter ..... in. at ..... $.....

..... Lead Joints at ..... $.....

..... Compound Joints at ..... $.....

..... Hrs. Foreman at ..... $.....

..... Hrs. Chauffeur at ..... $.....

..... Hrs. Tapper at ..... $.....

..... Hrs. Labor at ..... $.....

..... Hrs. Labor at ..... $.....

..... Hrs. Compressor at ..... $.....

..... Compensation Ins. ..... $.....

..... Trucking ..... $.....

..... Builders Use of Water ..... $.....

..... $.....

..... $.....

..... $.....

..... $.....

$.....

~~St.~~ ~~Pl.~~ Horicon Ave. Ave. No. 33

Name of Owner

Measured IN

~~Labor and Mat'l. Report~~ Dec 3 19 43

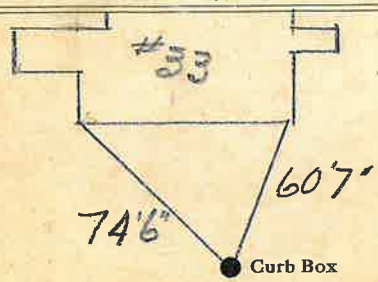


..... Main

Elev. of Main at tap .....

Gate at ● ● Gate at

● Curb Box

LSM-BC-6-1-45