LABOR AND MATERIALS

1	Copper / ~~Lead~~ Connection	3/4"	$ 3.04
1	Curb { Cock / ~~Valve~~ / ~~T. S. & V.~~ }	3/4" in.	$ 3.54
1	Service box Old returned { ~~Short 3½x4½~~ / Long 4½x5½ / ~~Buff or Rdway~~ }		$ 4.70
32 Ft.	3/4 in. { Copper / ~~G. I.~~ / ~~C. I.~~ } Pipe at	35	$ 11.20
	Nipples in. at		$
	Bushings to in. at		$
	Red'g / Inc'g { Coupl'gs to in. at		$
	Union in. at		$
	Meter in. at		$
	Lead Joints at		$
	Compound Joints at		$
2	Hrs. Water Maint. Man—1 at	1.23	$ 2.46
7	Hrs. Water Maint. Man—2 at	1.13	$ 7.91
23	Hrs. Labor— at	1.02	$ 23.46
	Hrs. Labor— at		$
3	Hrs. Compressor at	1.50	$ 4.50
	Compensation Ins. at $2.66 per C.		$ .90
	Trucking		$ 1.02
	Pav't Patch		$ 14.85
			$
			$
			$
	O'head		$
			$ 77.56

Tap made by Gifford
Sept 13 1951

~~St.~~
~~Pl.~~
Horican Ave. No. ~~36~~ 38

Name of Owner
Dr. Selinger

Labor and Mat'l. Report Sept 13 1951

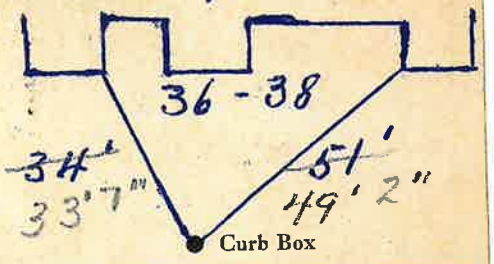

6" Main
Elev. of Main at tap 6'

Gate at ●
● Gate at

● Curb Box

Tap on Horican Ave.

LSM-6C 10-21-49