LABOR AND MATERIALS

1	Copper ~~Lead~~ Connection 3/4	$ 1.31
1	Curb Cock / Valve / T. S. & V. 3/4 in.	$ 1.75
1	Service Box Old returned Short 3½x4½ / Long 4½x5½ / Buff. or Rdway	$ 1.60
17	Ft. 3/4 in. Copper / ~~Galv. Iron~~ / ~~Cast Iron~~ Pipe at 18	$ 3.06
	Nipples ____ in. at	$
	Bushings ____ to ____ in. at	$
	Red'g / Inc'g Couplings ____ to ____ in. at	$
	Union ____ in. at	$
	Meter ____ in. at	$
	Lead Joints at	$
	Leadite Joints at	$
	Hrs. Foreman at	$
4	Hrs. Chauffeur at 6x1½	$ 2.50
	Hrs. Tapper at	$
16	Hrs. Labor at	$ 7.20
	Hrs. Labor at	$
	Hrs. Compressor at	$
	Compensation Ins.	$ .30
	Trucking	$ 1.—
	Builders Use of Water Patch	$ 5.00
	Tap by Penelli	$
		$
		$
		$
		$ 23.42

3 2 - - 1940

St.
Pl.
Ave. No. 3

Hovey St. cor. Woodlawn

Name of Owner

Carroll Champagne

Labor and Mat'l. Report June 12 1940

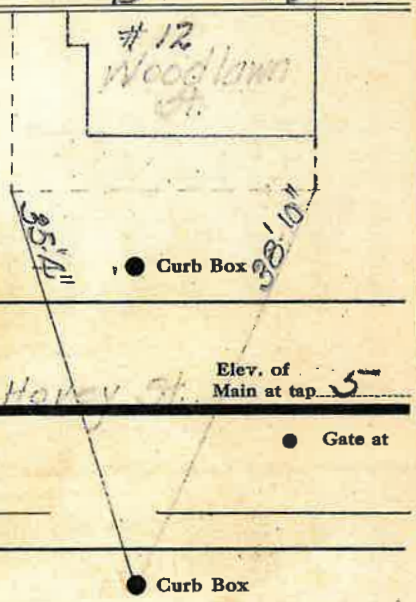

4 Main Hovey St. Elev. of Main at tap 5'

Gate at ● ● Gate at

● Curb Box

Hose Conn. for #3 Hovey St.
Measured from
#12 Woodlawn Ave.

Tap on Hovey St.

Hose conn for #3 Hovey St Measured from #12 Woodlawn Ave. Tap on Hovey St