LABOR AND MATERIALS

1 Copper ~~Lead~~ } Connection Same 3/4" $

1 Curb { Cock / Valve / ~~T. S. & V.~~ } 3/4 in. $

1 Service box Old returned { Short 3½ x 4½ / ~~Long 4½ x 5½~~ / ~~Buff or Rdway~~ } $

15 Ft. 3/4 in. { Copper / ~~G. I.~~ / ~~G. I.~~ } Pipe at $

Nipples in. at $

Bushings to in. at $

Red'g / Inc'g } Coupl'gs to in. at $

Union in. at $

Meter in. at $

Lead Joints at $

Compound Joints at $

Maintenance Foreman $

Hrs. Water Maint. Man—1 at $

Hrs. Water Maint. Man—2 at $

Hrs. Garage Foreman at $

Hrs. Labor— at $

Hrs. Compressor at $

Compensation Ins. at $ per C $

Trucking $

Pav't Patch $

Work by Giscord & Co. 9-19-60. $

$

O'head $

$

Used same corp stop. in 4" main. Tap made in 1931 when main was laid.

Hovey St. / ~~Pl.~~ / Ave. No. 8

Name of Owner

Leroux.

Labor and Mat'l. Report Sept. 19, 1960

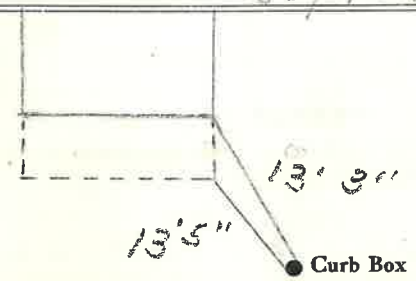

4" Main

Elev. of Main at tap 5'

Gate at ●

● Gate at

● Curb Box

LSM—5C—2-5-56