LABOR AND MATERIALS

1 Copper / Lead	Connection Same 1"	$
1 Curb	Cock / Valve / T. S. & V. 3/4 in. old	$ —
Service Box Old returned	Short 3½x4½ / Long 4½x5½ / Buff or Rdway Same	$
22 Ft. 3/4 in.	Copper / Galv Iron / Cast Iron Pipe at Tubeloy 18¢	$ 4.32
Nipples	in. at	$
Bushings	to in. at	$
1 Red'g / Inc'g	Couplings ½ to ¾ in. at	$ .15
Union	in. at	$
Meter	in. at	$
2 Lead Joints at	Iron to lead con.	$ .30
Leadite Joints at		$
Hrs. Foreman at		$
9 Hrs. Chauffeur at		$ 5.50
8 Hrs. Tapper at		$
Hrs. Labor at		$
Hrs. Labor at		$
Hrs. Compressor at		$ .35
Compensation Ins.		$ 1.00
Trucking		$ 10.41
Builders Use of Water		$
Tap by Hessel		$
		$
		$
		$ 28.22

11-43

St. 14
Pl.
Ave. No. 10

Hoyt

Name of Owner

Wells

Labor and Mat'l. Report July 13 19 43

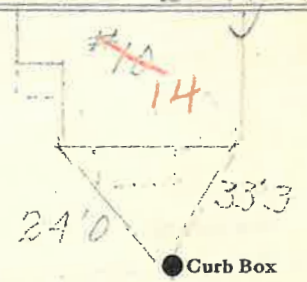

Main

Elev. of Main at tap

Gate at

Gate at

Curb Box

24' 0" 33' 3"