# LABOR AND MATERIALS

| | | | |
|---|---|---|---|
| 1 | Copper Lead | Connection 3/4" | $ 2.76 |
| 1 | Curb | Cock / Valve / T. S. & V. 3/4 in. | $ 3.49 |
| 1 | Service box | Old returned: Short 3½X4½ / ~~Long 4½X5½~~ / ~~Buff or Rdway~~ | $ 4.74 |
| 8 | Ft. 3/4 in. | Copper / ~~G. I.~~ / ~~C. I.~~ Pipe at 35 | $ 2.80 |
| | Nipples | in. at | $ |
| | Bushings | to in. at | $ |
| | Red'g Inc'g Coupl'gs | to in. at | $ |
| | Union | in. at | $ |
| | Meter | in. at | $ |
| | Lead Joints at | | $ |
| | Compound Joints at | | $ |
| 5 | Hrs. Water Maint. Man—1 at | | $ |
| 5 | Hrs. Water Maint. Man—2 at 1.24 | | $ 6.20 |
| 12 | Hrs. Labor— at 1.13 | | $ 13.56 |
| | Hrs. Labor— at | | $ |
| | Hrs. Compressor at | | $ |
| | Compensation Ins. at $ 4.406 per C | | $ .87 |
| | Trucking | | $ 1.00 |
| | Pav't Patch | | $ 9.00 |
| | Top by Gifford Dec 3-52 | | $ |
| | | | $ |
| | | | $ |
| | O'head | | $ |
| | | | $ 44.42 |

35.42

1952
112

St. Hoyt
Pl.
Ave. No. 17

Name of Owner Ralston

Labor and Mat'l. Report Dec. 3 1952

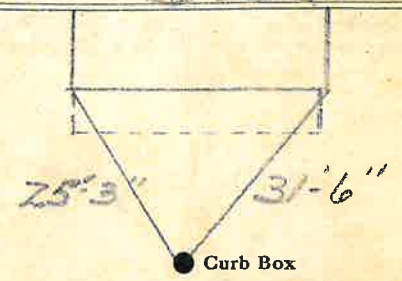


4" Main

Elev. of Main at tap 5'

Gate at ● ● Gate at

● Curb Box

LSM-5C 5 15-48