LABOR AND MATERIALS

_____ Copper / Lead } Connection _____ $ _____

_____ Curb { Cock / Valve / T.S. & V. } _____ in. _____ $ _____

_____ Service box / Old returned { Short 3-1/2 x 4-1/2 / Long 4-1/2 x 5-1/2 } _____ $ _____

_____ Ft. _____ in. { Copper / G.I. / C.I. } Pipe at _____ $ _____

_____ Nipples _____ in. at _____ $ _____

_____ Bushings _____ to _____ in. at _____ $ _____

_____ Red'g

_____ Inc'g

_____ Union _____ in. at _____ $ _____

_____ Meter _____ in. at _____ $ _____

_____ _____ $ _____

_____ Compound Joints at _____ $ _____

_____ Maintenance Foreman _____ $ _____

_____ Hrs. Water Maint. Man - 1 at _____ $ _____

_____ Hrs. Water Maint. Man - 2 at _____ $ _____

_____ Hrs. Garage Foreman _____ at _____ $ _____

_____ Hrs. Labor _____ at _____ $ _____

_____ Hrs. Compressor at _____ $ _____

_____ _____ $ _____

_____ Trucking _____ $ _____

_____ Pav't Patch _____ $ _____

_____ _____ $ _____

_____ _____ $ _____

_____ _____ $ _____

_____ _____ $ _____

$ _____

HUDSON St. Pl. Ave. No. 66

Name of Owner

Labor and Mat'l. Report 19

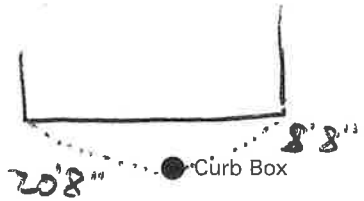

_____ Main

Elev. of Main at tap _____

Gate at ●

● Gate at

_____ _____

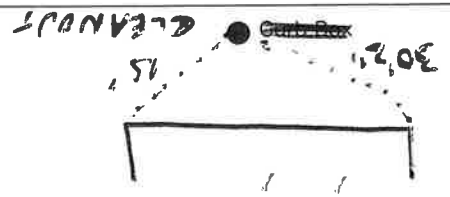

LABOR AND MATERIALS

1	Copper ~~Lead~~ Connection 3/4	$ 178
1	Curb Clock ~~Valve~~ ~~T. S. & V.~~ 3/4 in.	$ 261
1	Service box Old returned ~~Short 3½X4½~~ Long 4½X5½ ~~Buff or Rdway~~	$ 1.82
27	Ft. 3/4 in. Copper ~~Galv. Iron~~ ~~Cast Iron~~ Pipe at 23	$ 6.21
	Nipples in. at	$
	Bushings to in. at	$
	Red'g Inc'g Couplings to in. at	$
	Union in. at	$
	Meter in. at	$
	Lead Joints at	$
	Compound Joints at	$
3	Hrs. ~~Foreman~~ at WWM 84	$ 2.52
10	Hrs. Chauffeur at 75	$ 7.50
1	Hrs. Tapper at	$ 75
10	Hrs. Labor at 65	$ 6.50
	Hrs. Labor at	$
	Hrs. Compressor at	$
	Compensation Ins.	$ 48
	Trucking	$ 1.00
	Builders Use of Water ? Patch	$ 5.00
	Tap by Warsaiske	$
		$
		$
		$
		$ 36.17

✓

LSM-SC-6-1-45

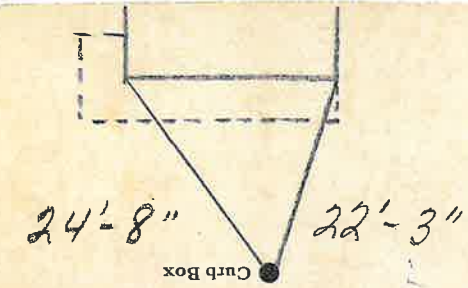

Gate at ● ● Gate at

6 Main Elev. of Main at tap 5

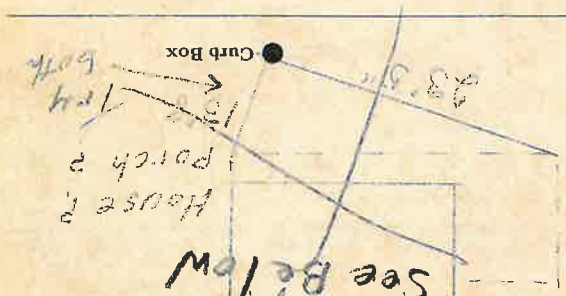

Labor and Mat'l. Report Cpl. 1 19 46

Name of Owner Carlow

St. Pl. Ave. No. 66

10-46