Labor and Materials

1	~~Lead~~ Connection	3/4	$
1	Curb Cock	3/4	$
1	Service Box ~~Old returned~~ (Short 3½ x 4½ / Long 4½ x 5½ / Buffalo)		$
10	Ft. Cop. in. G. I. Pipe at		$
	Nipples ... in. at		$
	Bushings ... to ... in. at		$
	Red'g Coup ... to ... in. at		$
	Inc'g Coup ... to ... in. at		$
	Union ... in. at		$
	Meter ... in. at		$
	Cu. Yds. Br. Stone at		$
	Cu. Yds. Sand at		$
	Bags Cement at		$
	Paving Brick (Mack / Red / Asphalt) at		$
3	Hrs. Foreman at		$
17	Hrs. Common Labor at		$
	Hrs. Mason at		$
	Hrs.	at	$
	Hrs.	at	$
900	Builders' Use of Water		$
		at	$
	Truck	at	$
		at	$
		at	$
		Total	$ 13.09

37

Labor and Material Report May 26 1925


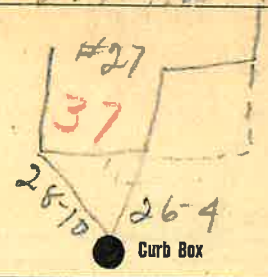

6" Main

Elev. of Main at tap 6"

Gate at ● ● Gate at

● Curb Box

Shut off at Curb 9/18/73