LABOR AND MATERIALS

1	Copper Lead	Connection 3/4	$ 1.79
1	Curb { Clock Valve T. S. & V. }	3/4 in.	$ 2.61
1	Service box Old returned	{ Short 3½X4½ Long 4½X5½ Buff or Rdway }	$ 1.82
26	Ft. 3/4 in.	{ Copper Galv. Iron Cast Iron } Pipe at 23	$ 5.98
	Nipples	in. at	$
	Bushings	to in. at	$
	Red'g Inc'g Couplings	to in. at	$
	Union	in. at	$
	Meter	in. at	$
	Lead Joints at		$
	Compound Joints at		$
	Hrs. Foreman at		$
	Hrs. Chauffeur at		$
14	Hrs. Tapper at	8 2/4	$ 1.24
	Hrs. Labor at		$
2	Hrs. Labor at	7 1/4	$ 1.43
	Hrs. Compressor at		$
	Compensation Ins.		$ .07
	Trucking		$ 1.—
	Builders Use of Water		$ —
	Tapping Machine		$
			$
			$
			$
			$ 15.94

65-146

St. New
Pl.
Hunter St Ave. No. 146 (132)

Name of Owner

Ball

Labor and Mat'l. Report Nov 8 1946

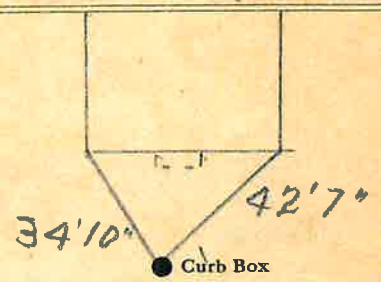

6 Main

Elev. of Main at tap 4

Gate at ●

● Gate at

● Curb Box

LSM-5C-6-1-45