## LABOR AND MATERIALS

| | | | |
|---|---|---|---|
| 1 | Copper ~~Lead~~ Connection | 3/4 | $ 1.80 |
| 1 | Curb { Clock / ~~Valve~~ / ~~T. S. & V.~~ } | 3/4 in. | $ 3.60 |
| 1 | Service box ~~Old returned~~ { Short 3⅛X4⅛ / ~~Long 4⅛X5⅛~~ / ~~Buff or Rdway~~ } | | $ 5.80 |
| 14 Ft. | 3/4 in. { Copper / ~~Galv. Iron~~ / ~~Cast Iron~~ } Pipe at | 35 | $ 4.90 |
| | Nipples ... in. at | | $ |
| | Bushings ... to ... in. at | | $ |
| | Red'g / Inc'g Couplings ... to ... in. at | | $ |
| | Union ... in. at | | $ |
| | Meter ... in. at | | $ |
| | Lead Joints at | | $ |
| | Compound Joints at | | $ |
| | Hrs. Foreman at | | $ |
| | Hrs. Chauffeur at | | $ |
| 10 | Hrs. Tapper at | 91 | $ 9.10 |
| 24 | Hrs. Labor at | 80 | $ 19.20 |
| | Hrs. Labor at | | $ |
| | Hrs. Compressor at | | $ |
| | Compensation Ins. | | $ .62 |
| | Trucking | | $ 1.— |
| | Builders Use of Water | | $ |
| | Tap by Mosher | | $ |
| | | | $ |
| | | | $ |
| | | | $ |

$ 47.02

119-47

St. / Pl. / Ave. No. Hunter St 147

Name of Owner

Ball

Labor and Mat'l. Report Sept 3 19 47

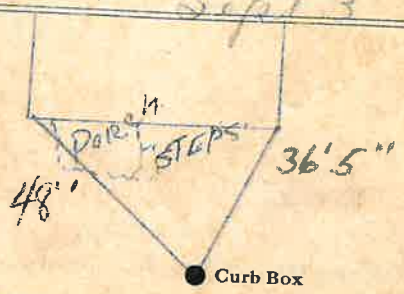


6 Main — Elev. of Main at tap 5

Gate at ● — ● Gate at

● Curb Box

- NEW 3/4" COPPER - CITY SIDE

1995

LSM-5C-6-1-45