LABOR AND MATERIALS

1	Copper Lead } Connection	3/4	$ 2.94
1	Curb { Clock Valve T. S. & V. }	3/4 in.	$ 3.71
1	Service box Old returned { Short 3½X4⅓ Long-4⅓X5⅓ Buff or Rdway }		$ 5.90
8	Ft. 3/4 in. { Copper Galv. Iron Cast Iron } Pipe at	30	$ 2.40
	Nipples ... in. at		$
	Bushings ... to ... in. at		$
	Red'g Inc'g } Couplings ... to ... in. at		$
	Union ... in. at		$
	Meter ... in. at		$
	Lead Joints at		$
	Compound Joints at		$
7	Hrs. Foreman at	1.01	$ 7.07
	Hrs. Chauffeur at		$
	Hrs. Tapper at		$
2.5	Hrs. Labor at	.80	$ 2.00
	Hrs. Labor at		$
4	Hrs. Compressor at	1.20	$ 4.80
	Compensation Ins.		$ .60
	Trucking		$ 1.—
	Builders Use of Water.		$ —
Tap by Miller			$
			$
			$
			$
			$ 48.42

1

St. ~~Pl.~~ Ave. No. 149

Hunter

Name of Owner

Ball

Labor and Mat'l. Report Dec 16 1947

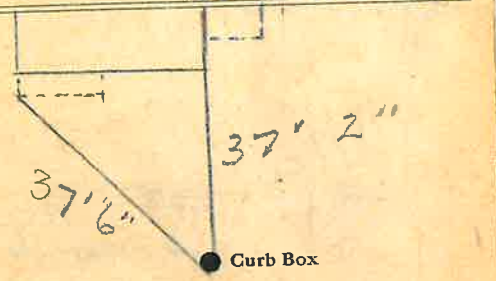

6 Main

Elev. of Main at tap 4½

Gate at ●

● Gate at

● Curb Box

LSM-5C-6-1-45