## LABOR AND MATERIALS

| | | | |
|---|---|---|---|
| 1 | Copper Lead — Connection | 3/4 | $ 2.94 |
| 1 | Curb — Clock Valve / T. S. & V. | 3/4 in. | $ 3.71 |
| 1 | Service box Old returned — Short 3⅛X4⅛ / Long 4⅛X5⅛ / Buff or Rdway | | $ 5.90 |
| 28 | Ft. 3/4 in. — Copper / Galv. Iron / Cast Iron — Pipe at 30 | | $ 8.40 |
| | Nipples in. at | | $ |
| | Bushings to in. at | | $ |
| | Red'g / Inc'g Couplings to in. at | | $ |
| | Union in. at | | $ |
| | Meter in. at | | $ |
| | Lead Joints at | | $ |
| | Compound Joints at | | $ |
| 7 | Hrs. Foreman at | 1.01 | $ 7.07 |
| | Hrs. Chauffeur at | | $ |
| | Hrs. Tapper at | | $ |
| 26 | Hrs. Labor at | .80 | $ 20.80 |
| | Hrs. Labor at | | $ |
| 4 | Hrs. Compressor at | 1.20 | $ 4.80 |
| | Compensation Ins. | | $ .62 |
| | Trucking | | $ 1. |
| | Builders Use of Water | | $ |
| | Tapping Valve | | $ |
| | | | $ |
| | | | $ |
| | | | $ |
| | | | $ 55.24 |

2

St. / Pl. Ave. No. 150 Hunter

Name of Owner

Ball

Labor and Mat'l. Report Dec 10 1947

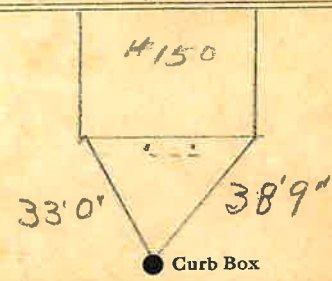


6 Main — Elev. of Main at tap 4½

Gate at ● — ● Gate at

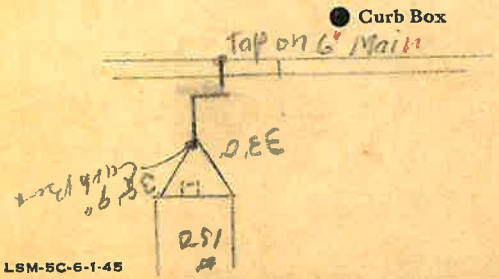


LSM-5C-6-1-45