Labor and Materials

1	Lead Connection 3/4	$
1	Curb Cock 1"	$
1	Service Box Old returned { Short 3½ x 4½ / ~~Long 4½ x 5½~~ / Buffalo	$
24	Ft. 3/4 in. ~~G. I.~~ COOPER Pipe at	$
	Nipples in. at	$
	Bushings to in. at	$
	Red'g Coup to in. at	$
	Inc'g Coup to in. at	$
	Union in. at	$
	Meter in. at	$
	Cu. Yds. Br. Stone at	$
	Cu. Yds. Sand at	$
	Bags Cement at	$
	Paving Brick { Mack / Red / Asphalt } at	$
6	Hrs. Foreman at	$
7	Hrs. Common Labor at	$
	Hrs. Mason at	$
	Hrs. at	$
	Hrs. at	$
Jan	Builders' Use of Water	$
	at	$
	Truck 10-0 at	$
	at	$
	at	$
	Total	$ 18.72

63

Labor and Material Report May 19 1924

3/4" tap at 57 East Harter st

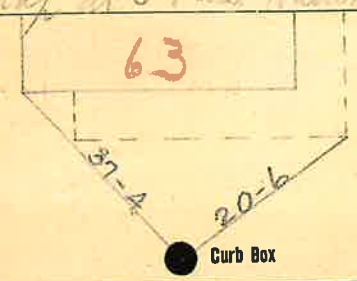

4" Main

Elev. of Main at tap 4 ft

Gate at ●

● Gate at

● Curb Box

NEW 3/4" COOPER - 1994