LABOR AND MATERIALS

1	Copper / ~~Lead~~ Connection 3/4	$ 1.23
1	Curb { Cock / ~~Valve~~ / ~~T. S. & V.~~ } 3/4 in.	$ 1.68
1	Service Box Old returned { Short 3½x4½ / Long 4½x5½ / Buff. or Rdway }	$ 1.54
14	Ft. 3/4 in. { Copper / ~~Galv Iron~~ / ~~Cast Iron~~ } Pipe at 17	$ 2.38
	Nipples ____ in. at	$
	Bushings ____ to ____ in. at	$
	Red'g / Inc'g Couplings ____ to ____ in. at	$
	Union ____ in. at	$
	Meter ____ in. at	$
	Lead Joints at	$
	Leadite Joints at	$
	Hrs. Foreman at	$
2	Hrs. Chauffeur at 62½	$ 1.25
4	Hrs. Tapper at	$ 2.50
4	Hrs. Labor at 45	$ 1.80
	Hrs. Labor at	$
	Hrs. Compressor at	$
	Compensation Ins.	$ .17
	Trucking	$ 1.—
	Builders Use of Water Patch	$ 5.—
	Tap by Hessel	$
		$
		$
		$
		$ 18.55

8 0 - - 1939

St. 64 HB
Pl.
Hunter St Ave. No. 67 + 58

Name of Owner

Dr P. Boyle

Labor and Mat'l. Report Oct 2 1939

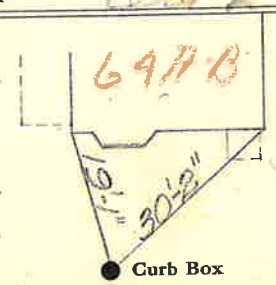

4 Main

Elev. of Main at tap 5

Gate at ●

● Gate at

● Curb Box

Old Shut. off