LABOR AND MATERIALS

1	Copper ~~Lead~~	Connection 3/4	$ 2.80
1	Curb { Clock / ~~Valve~~ / T. S. & V. }	3/4 in.	$ 3.60
	Service box ~~Old-returned~~	{ Short 3⅛X4⅛ / Long 4⅛X5⅛ / Buff or Rdway } Same	$ —
12	Ft. 3/4 in.	{ Copper / ~~Galv. Iron~~ / ~~Cast Iron~~ } Pipe at 35	$ 4.20
	Nipples	in. at	$
	Bushings	to in. at	$
	Red'g / Inc'g Couplings	to in. at	$
	Union	in. at	$
	Meter	in. at	$
	Lead Joints at		$
	Compound Joints at		$
	Hrs. Foreman at		$
	Hrs. Chauffeur at		$
4	Hrs. Tapper at	91	$ 3.64
15	Hrs. Labor at	80	$ 12.00
	Hrs. Labor at		$
	Hrs. Compressor at		$
	Compensation Ins.		$ .35
	Trucking		$ 1.—
	Builders Use of Water		$ 4.70
	Tap by Magnum		$
			$
			$
			$
			$ 32.29

136-47

Hamlet St. ~~Pl.~~ ~~Ave.~~ No. 66

Name of Owner

Dougherty

Labor and Mat'l. Report Oct 9 1947

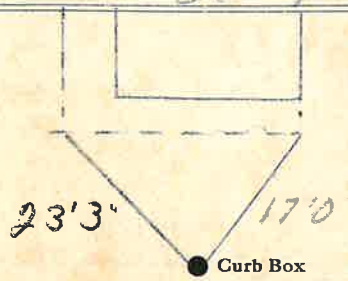

4 Main

Elev. of Main at tap 5

Gate at ● ● Gate at

● Curb Box

LSM-5C-6-1-45