LABOR AND MATERIALS

1	Copper ~~Lead~~ Connection 3/4		$ 2.80
1	Curb Clock ~~Valve~~ ~~T. S. & V.~~ 3/4 in.		$ 3.60
1	Service box Old returned Short 3½X4½ Long 4½X5½ Buff or Rdway	Same	$ —
25	Ft. 3/4 in. Copper ~~Galv. Iron~~ ~~Cast Iron~~ Pipe at 35		$ 8.75
	Nipples in. at		$
	Bushings to in. at		$
	Red'g Inc'g Couplings to in. at		$
	Union in. at		$
	Meter in. at		$
	Lead Joints at		$
	Compound Joints at		$
	Hrs. Foreman at		$
	Hrs. Chauffeur at		$
7	Hrs. Tapper at	91	$ 6.37
13	Hrs. Labor at	80	$ 10.40
	Hrs. Labor at		$
	Hrs. Compressor at		$
	Compensation Ins.		$ .37
	Trucking		$ 1.7
	Builders Use of Water		$ 10.50
	Taply Mag		$
			$
			$
			$
			$ 43.79

153 J 47

Hunter St. ~~Pl.~~ ~~Ave.~~ No. 67

Name of Owner

Paul Gardner

Labor and Mat'l. Report Sept 30 1947

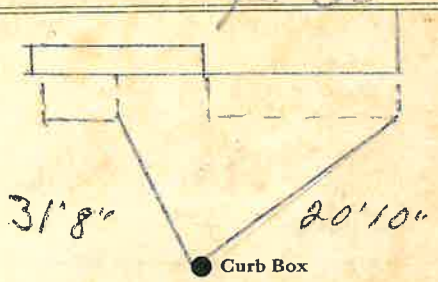

4 Main

Elev. of Main at tap 5

Gate at

Gate at

Curb Box

LSM-5C-6-1-45