LABOR AND MATERIALS

1	Copper Lead } Connection	3/4	$ 1.59
1	Curb { Clock Valve T. S. & V. }	3/4 in.	$ 2.74
Same	Service box Old returned { Short 3½X4⅛ Long 4⅛X5⅛ Buff or Rdway }		$ —
29 Ft.	3/4 in. { Copper Galv. Iron Cast Iron } Pipe at	19	$ 5.51
	Nipples ..... in. at		$
	Bushings ..... to ..... in. at		$
	Red'g Inc'g } Couplings ..... to ..... in. at		$
	Union ..... in. at		$
	Meter ..... in. at		$
	Lead Joints at		$
	Compound Joints at		$
2	Hrs. Foreman at WWM	84	$ 1.68
6	Hrs. Chauffeur at	75	$ 4.50
6	Hrs. Tapper at	75	$ 4.50
6	Hrs. Labor at	65	$ 3.90
	Hrs. Labor at		$
1	Hrs. Compressor at	87½	$ .88
	Compensation Ins.		$ .46
	Trucking		$ 1.—
	Builders Use of Water. Patch		$ 5.00
	Tapp Magazine		$
			$
			$
			$
			$ 31.75

33 x 45

Harlan

St. 69
Pl.
Ave. No. 63

Name of Owner

Crimmins

Labor and Mat'l. Report Oct 16 19 45

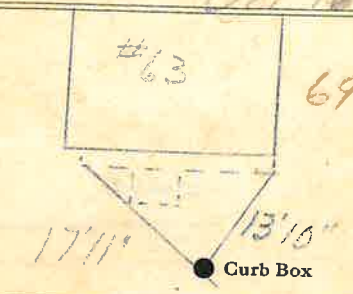

4" Main

Elev. of Main at tap 4'

Gate at ●

● Gate at

● Curb Box

4

LSM-5C-6-1-45