LABOR AND MATERIALS

1	Copper / ~~Lead~~ Connection	3/4	$ 2.87
1	Curb { Cock / ~~Valve~~ / ~~T. S. & V.~~ }	3/4 in.	$ 3.60
1	Service box { Short ~~3½X4½~~ / Long ~~4½X5½~~ / Buff or Rdway } Old returned	3'	$ 4.68
27	Ft. 3/4 in. { Copper / ~~G. I.~~ / C. I. }	Pipe at 32	$ 8.64
	Nipples ... in. at		$
	Bushings ... to ... in. at		$
	Red'g / Inc'g Coupl'gs ... to ... in. at		$
	Union ... in. at		$
	Meter ... in. at		$
	Lead Joints at		$
	Compound Joints at		$
1	Hrs. Water Maint. Man—1 at	1.12	$ 1.12
12	Hrs. Water Maint. Man—2 at	1.02	$ 12.24
24	Hrs. Labor— ... at	.91	$ 21.84
	Hrs. Labor— ... at		$
2	Hrs. Compressor at	1.70	$ 3.40
	Compensation Ins. at $ 2.18 per C		$ .77
	Trucking		$ 2.00
	Pav't Patch		$ 10.25
	Tap 3/4 Meeum		$
			$
			$
	O'head		$
			$ 70.43

94

St. Hunter Pl. Ave. No. 88

Name of Owner

Sullivan

Labor and Mat'l. Report Aug 30 1949

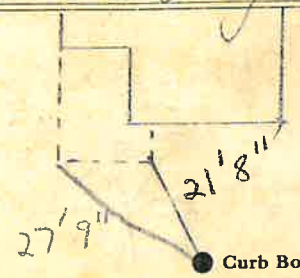

6 Main

Elev. of Main at tap 3'

Gate at ● ● Gate at

27' to main
3/4" copper

● Curb Box

Replaced Buffalo Box
w/ curb box
4-17-68

LSM-SC 5 19-48