LABOR AND MATERIALS

1	Copper ~~Lead~~ Connection	3/4"	$ 3.20
1	Curb {Clock, ~~Valve, T. S. & V.~~}	3/4 in.	$ 1.00
1	Service box ~~Old returned~~ {Short 3½X4½, ~~Long 4½X5½~~, Buff or Rdway}		$ 1.30
24	Ft. 3/4 in. {Copper, ~~Galv. Iron, Cast Iron~~} Pipe at		$ 5.50
	Nipples in. at		$
	Bushings to in. at		$
1	~~Red'g~~ Couplings Brass to in. at		$ .15
	Union in. at		$
	Meter in. at		$
	Lead Joints at		$
	Compound Joints at		$
5	Hrs. Foreman at 62.5		$ 3.12
	Hrs. Chauffeur at		$
	Hrs. Tapper at		$
2.6	Hrs. Labor at 40 5/8		$ 10.55
	Hrs. Labor at		$
	Hrs. Compressor at		$
	Compensation Ins.		$ .36
Yes	Trucking		$ 1.00
Yes	Builders Use of Water		$
	Measure by Magnum		$
			$
			$
			$
			$ 26.18

St. ~~Pl.~~ ~~Ave.~~ No. 100 Hunter 84

Name of Owner

TAX ID # 303.13-3-18

Labor and Mat'l. Report May 4 1927

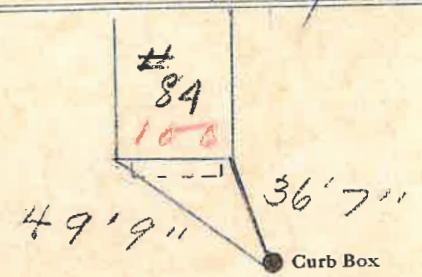

6" Main Elev. of Main at tap 4'

Gate at ● ● Gate at

24' to main

3/4" COPPER ● Curb Box

LSM-5C-6-1-45