LABOR AND MATERIALS

1	Copper ~~Lead~~ Connection	3/4	$ 1.35
1	Curb { ~~Cock~~ ~~Valve~~ ~~T. S. & V.~~ }	3/4 in.	$ 1.80
1	Service Box ~~Old returned~~ { ~~Short 3½x4½~~ Long 4½x5½ ~~Buff or Rdway~~ }		$ 1.70
27 Ft. 3/4 in.	{ Copper ~~Galv Iron~~ ~~Cast Iron~~ } Pipe at 18		$ 4.86
	Nipples ..... in. at		$
	Bushings ..... to ..... in. at		$
	Red'g Inc'g } Couplings ..... to ..... in. at		$
	Union ..... in. at		$
	Meter ..... in. at		$
	Lead Joints at		$
	Leadite Joints at		$
	Hrs. Foreman at		$
2	Hrs. Chauffeur at		$ 1.25
	Hrs. Tapper at		$
4	Hrs. Labor at		$ 1.80
	Hrs. Labor at		$
	Hrs. Compressor at		$
	Compensation Ins.		$ .10
	Trucking		$ 1.—
	Builders Use of Water 1½ patch (sewer)		$ 2.50
	Tap by Hesse		$
			$
			$
			$
			$ 16.36

3 9 1941

St. 136
~~Pl.~~
Ave. No. 122

Hunter

Name of Owner

Griffin

Labor and Mat'l. Report June 10 1941

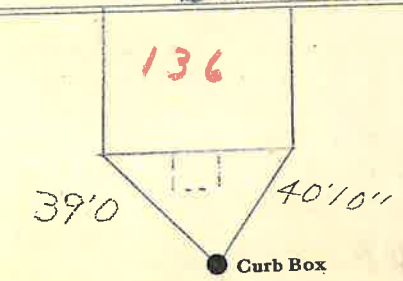

6 Main

Elev. of Main at tap 5

Gate at

Gate at

Curb Box