## LABOR AND MATERIALS

| | | |
|---|---|---|
| 1 | Copper ~~Lead~~ Connection 3/4 | $ 1.35 |
| 1 | Curb { ~~Cock Valve T. S. & V.~~ } 3/4 in. | $ 1.88 |
| 1 | Service Box ~~Old returned~~ { Short 3½x4½ / Long 4½x5½ / Buff. or Rdway } | $ 1.82 |
| 9 Ft. 3/4 in. | { Copper / ~~Galv Iron~~ / Cast Iron } Pipe at 20 | $ 1.80 |
| | Nipples ____ in. at | $ |
| | Bushings ____ to ____ in. at | $ |
| | Red'g / Inc'g Couplings ____ to ____ in. at | $ |
| | Union ____ in. at | $ |
| | Meter ____ in. at | $ |
| | Lead Joints at | $ |
| | Leadite Joints at | $ |
| | Hrs. Foreman at | $ |
| 2½ | Hrs. Chauffeur at 68¾ | $ 1.73 |
| 1½ | Hrs. Tapper at | $ 1.04 |
| 2½ | Hrs. Labor at 55 | $ 1.38 |
| | Hrs. Labor at | $ |
| | Hrs. Compressor at | $ |
| | Compensation Ins. | $ .13 |
| | Trucking | $ 1.— |
| | Builders Use of Water | $ |
| Warsinski | | $ |
| | | $ |
| | | $ |
| | | $ |
| | | $ 12.13 |

H.

1 7 1942

St. ~~Pl.~~ ~~Ave.~~ Hunter No. 125 139

**Name of Owner**

Griffin

**Labor and Mat'l. Report** May 5 1942

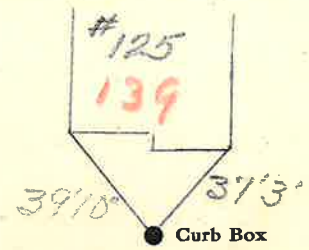


6" Main

Elev. of Main at tap 5

Gate at ● ● Gate at

● Curb Box